


DO NOT SCALE  
 DIMENSIONS ARE APPROXIMATE  
 CHECK ALL DIMENSIONS BEFORE CONSTRUCTION

**AREAS TO BE LICENSED**

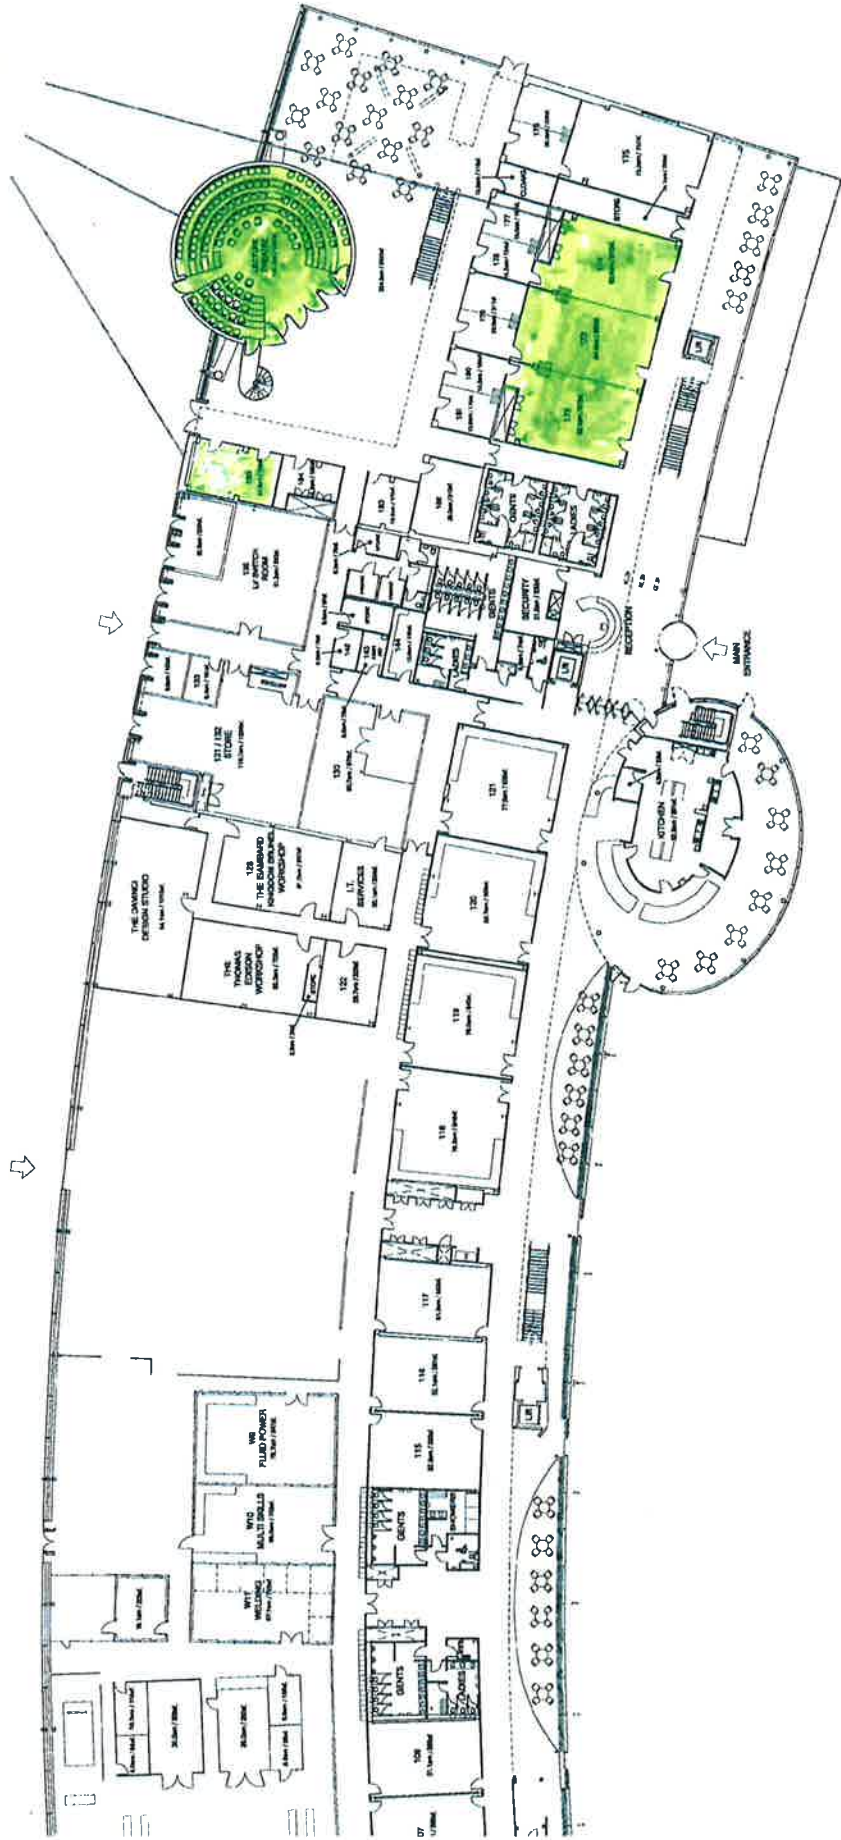

PROJECT	CEME Campus	NO. 1	DATE	1.2.20
LOCATION	Marsh Way, Rainham, Essex, RM13 8EU.	NO. 2	DATE	Nov 20
CLIENT	As Built Survey	NO. 3	DATE	10/1
DESIGNER	Ground Floor Plan (2 of 2).	NO. 4	DATE	
DRAWN	08264_02	NO. 5	DATE	
CHECKED		NO. 6	DATE	
DATE		NO. 7	DATE	

ATP Group Building Services  
 Brook House, Chantry Road, Bard, Essex, ES1 4OP  
 T: 020 8532 4141 F: 020 8532 4140 E: atp.hord@atpgroup.co.uk

Blue :504.8sm /5433sf.

Green:939.6sm /10113sf.

Pink:359.2sm /3866sf.

